



EXISTING LOWER GROUND FLOOR PLAN
SCALE 1/100




EXISTING GROUND FLOOR PLAN
SCALE 1/100

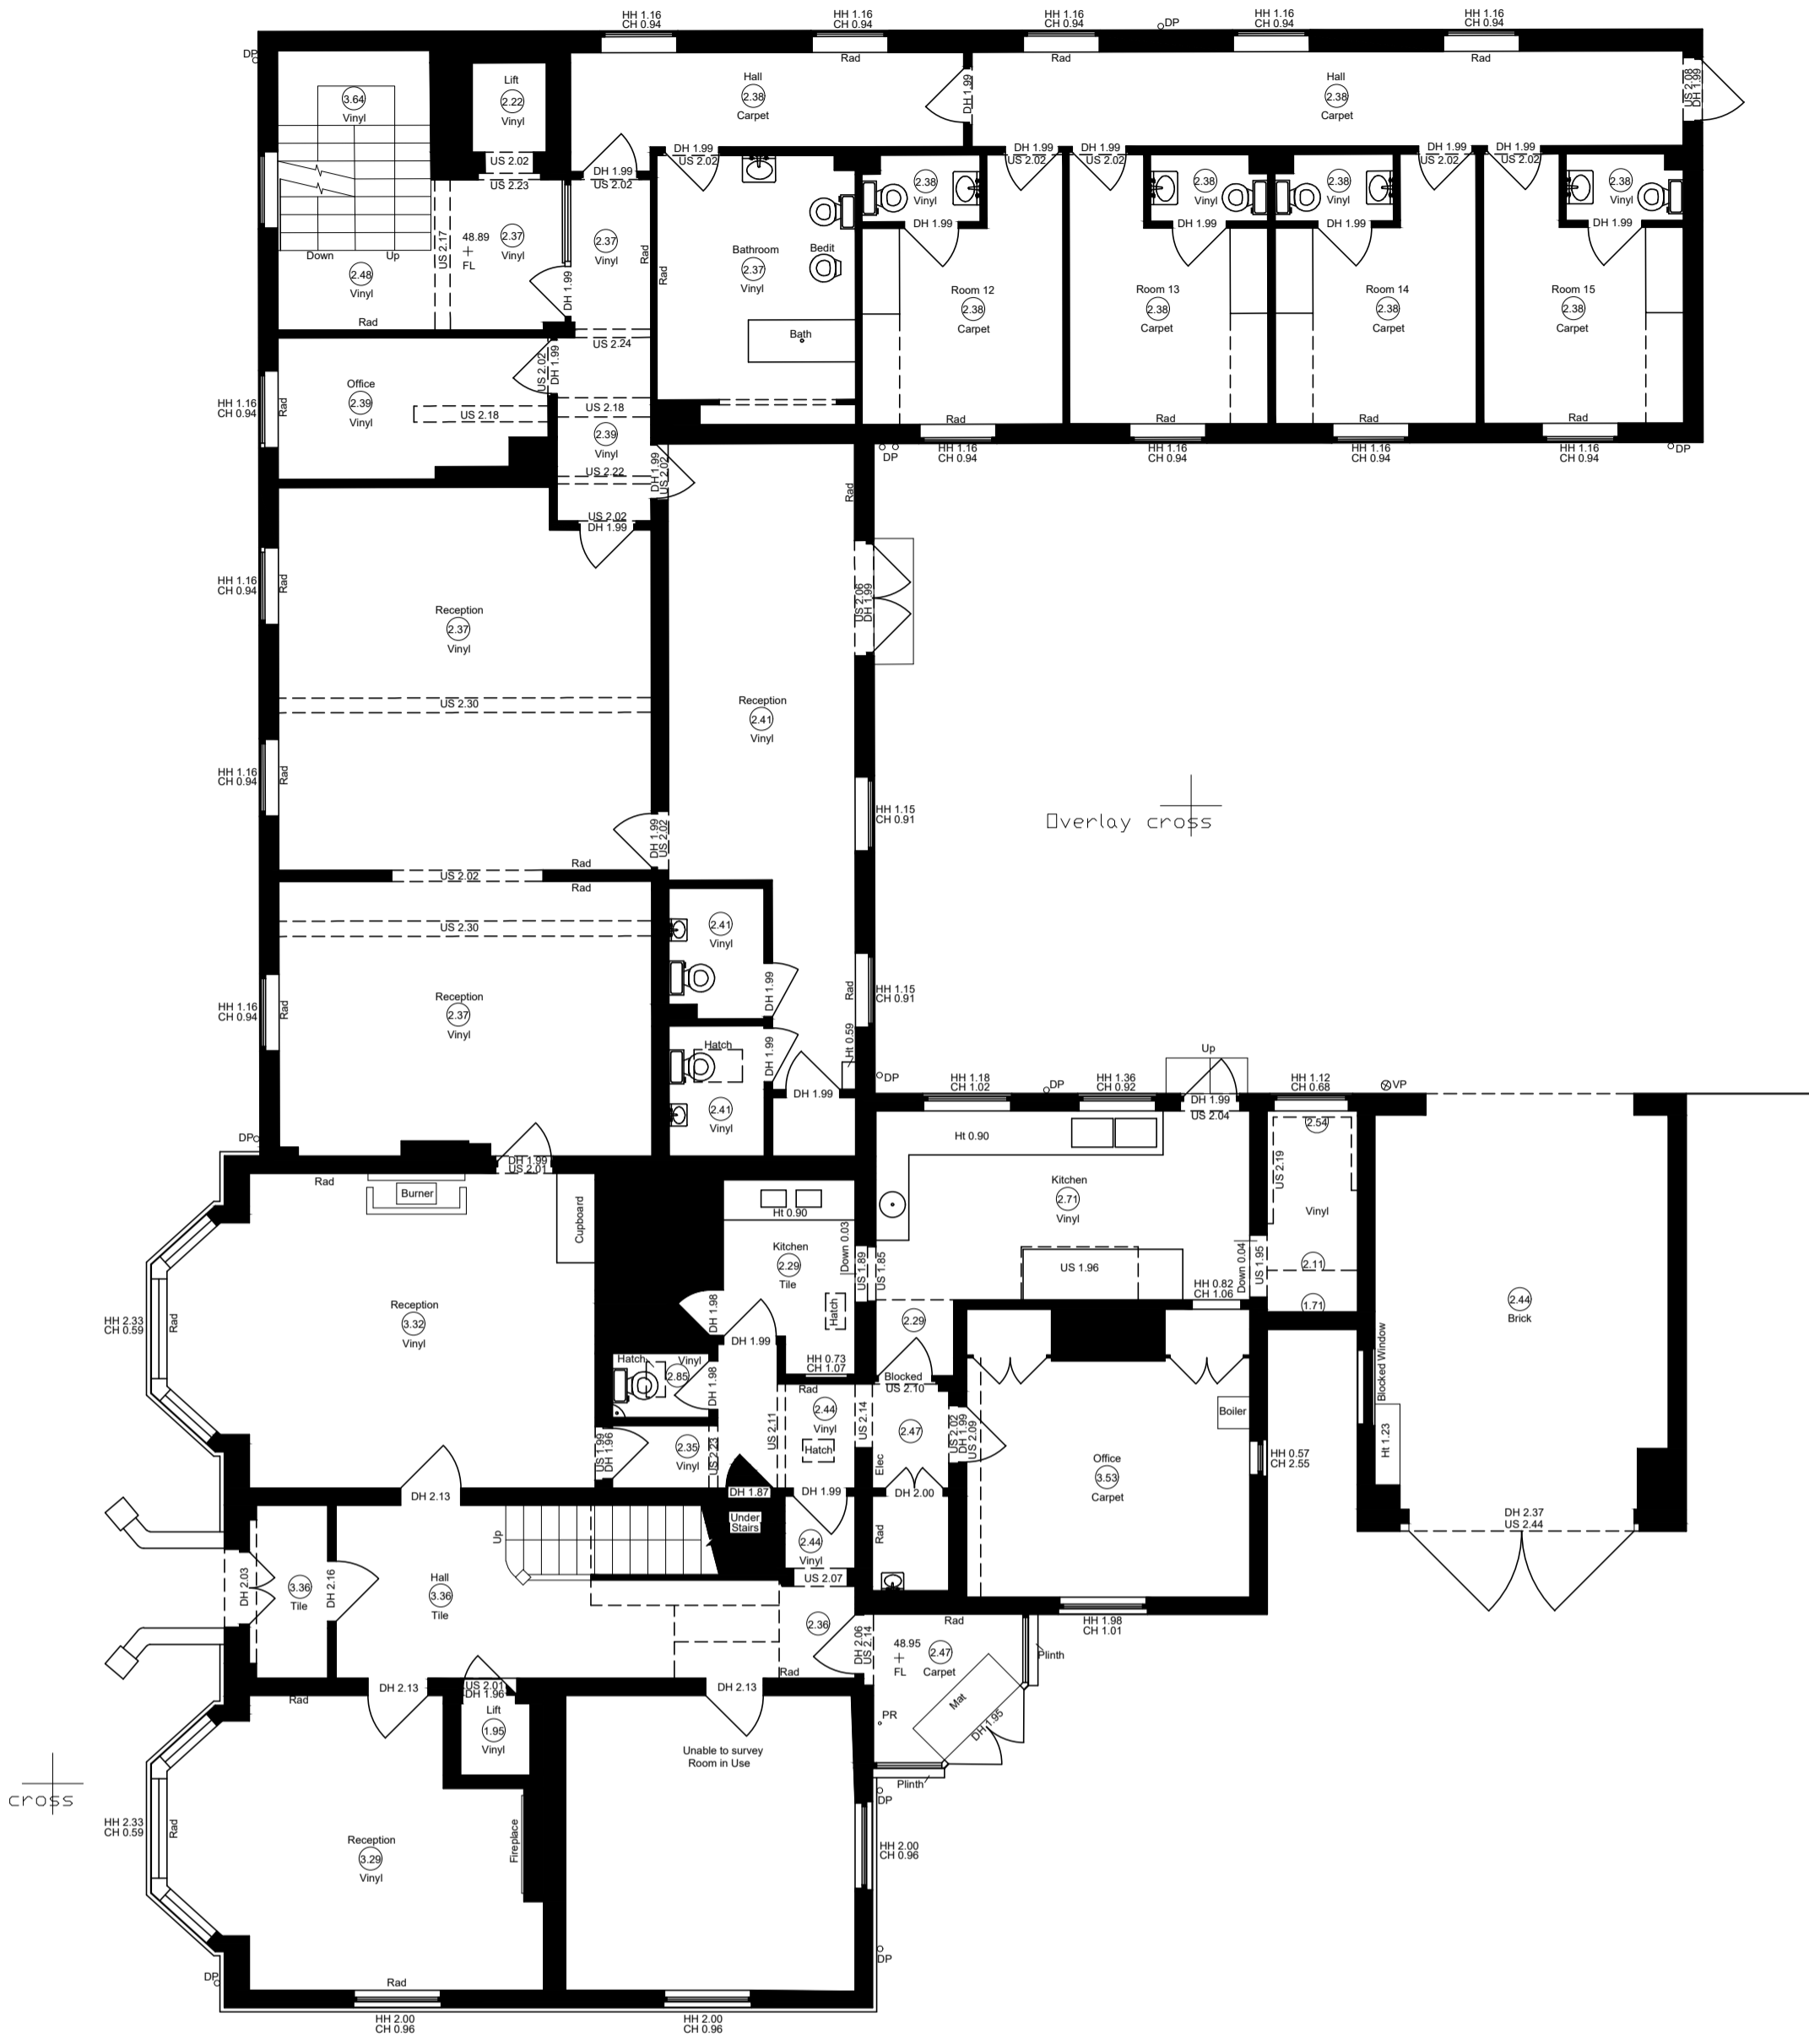

EXISTING FIRST FLOOR PLAN
SCALE 1/100

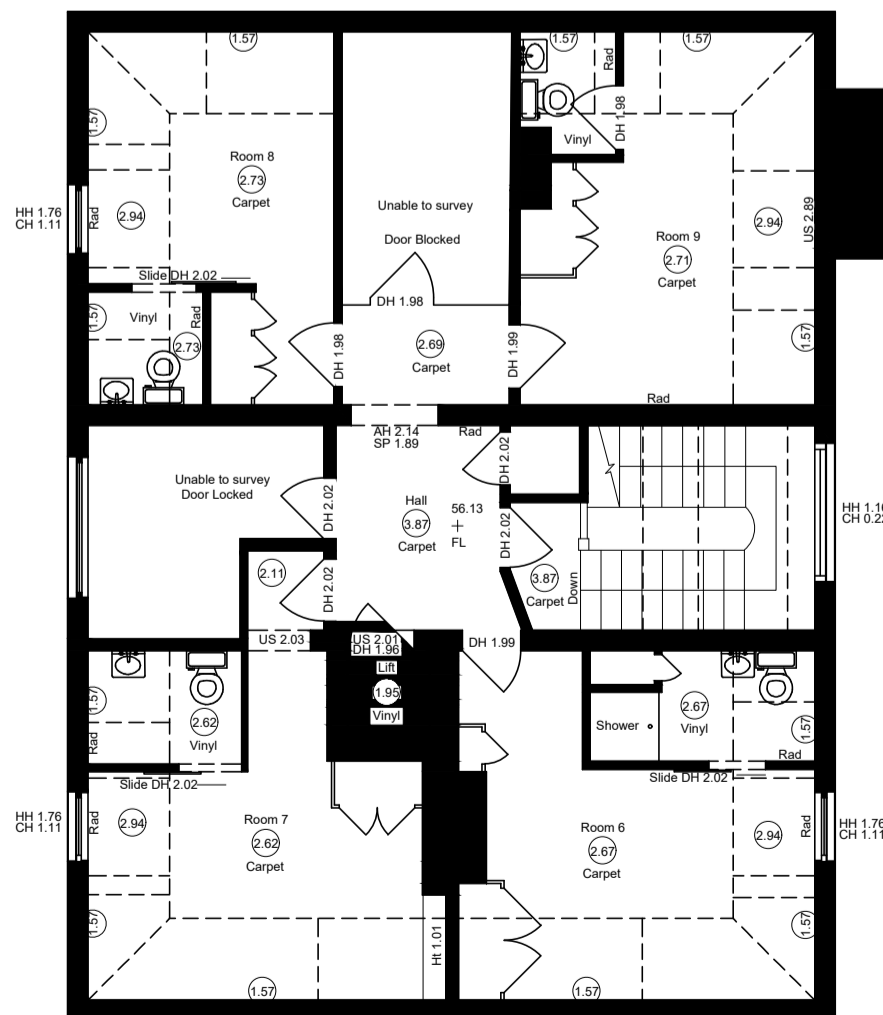

EXISTING SECOND FLOOR PLAN
SCALE 1/100

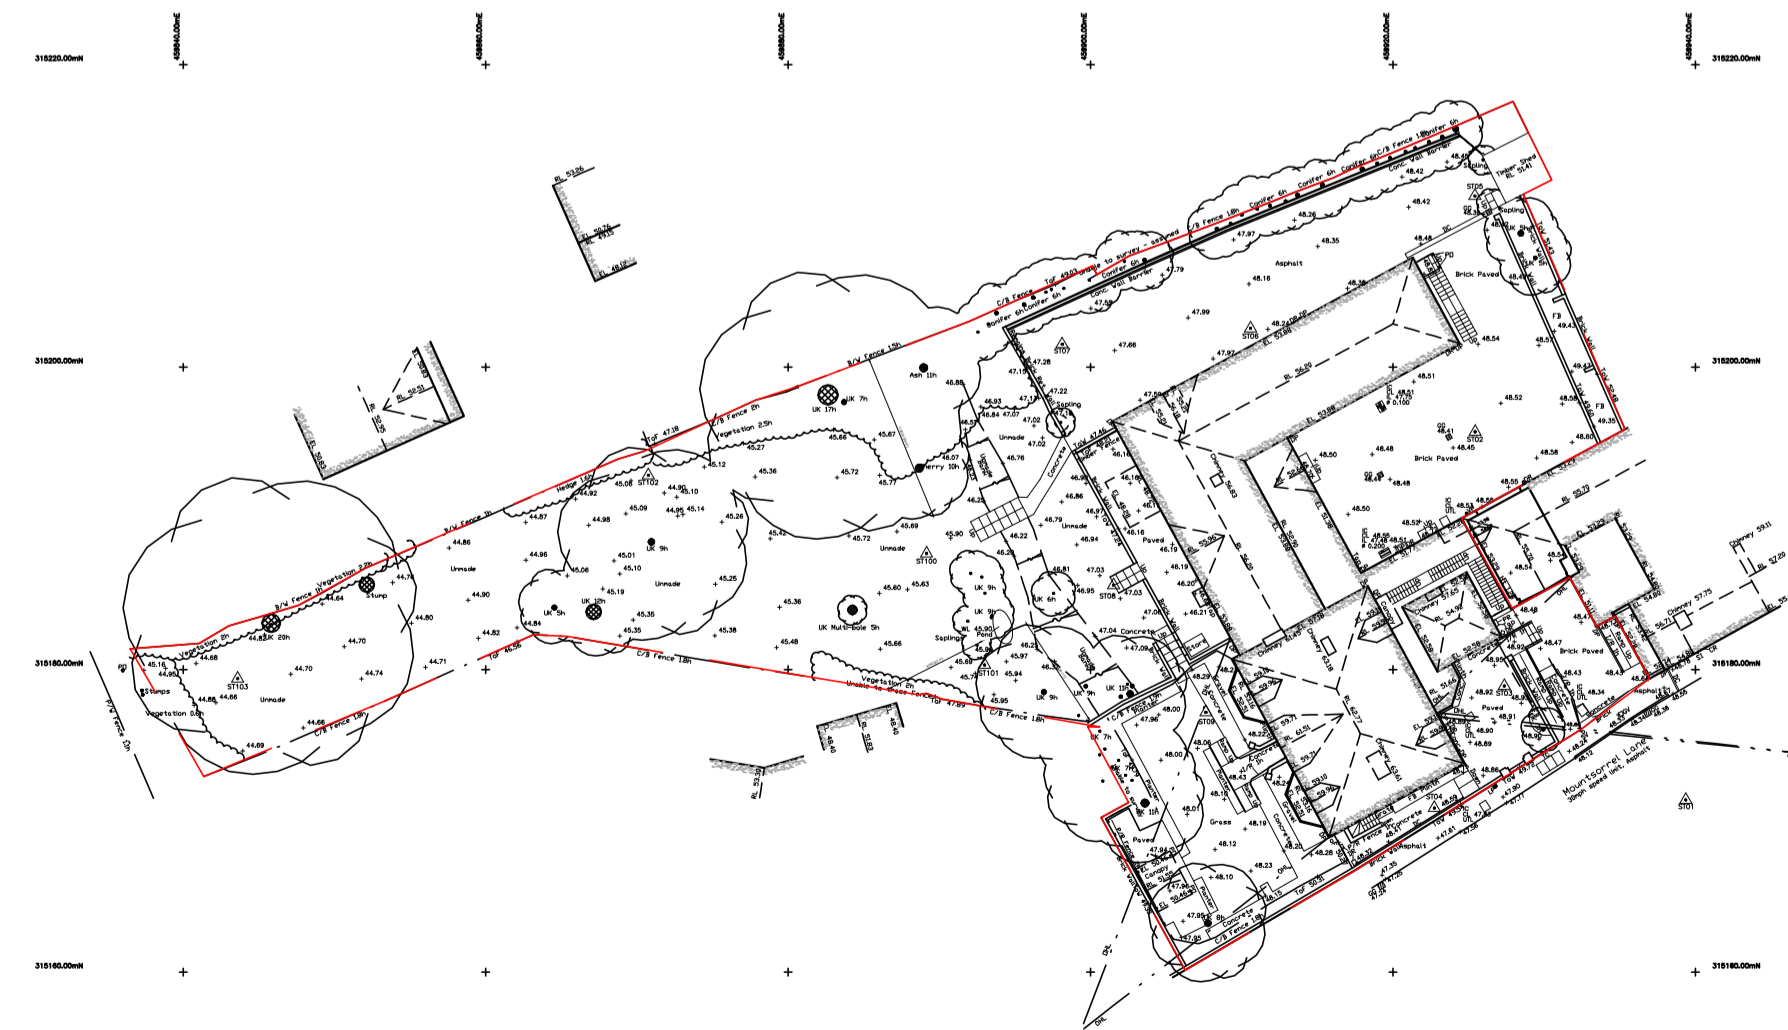


EXISTING SITE PLAN
SCALE 1/500

Revision: X - XXXX17 - XX - XXXXXXXXX



Regent House,
7 Upper King Street,
Leicester LE1 6XB
Tel: 0116 251 0606
E: info@ds-a.co.uk
W: www.ds-a.co.uk

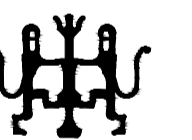

Drawing Stage	
FEASIBILITY	TENDER
PLANNING	● CONSTRUCTION
BUILDING REGULATIONS	AS BUILT

Project: 20132 - Highbury Care Home, 38 Mountsrorrel Lane, Silby Loughborough, LE12 7NF

Client: Mr V Sudera

Sheet Title: Planning Application - Existing Survey

Ref: DSA-20132-PL-ES-01-A

Scale: Various @ A1

Date: 10-02-2021

Drawn: S.B. Checked: S.B.

THIS DRAWING IS ISSUED FOR THE SOLE AND EXCLUSIVE USE OF THE NAMED RECIPIENT. DISTRIBUTION TO ANY THIRD PARTY IS ON THE STRICT UNDERSTANDING THAT NO LIABILITY IS ACCEPTED BY DESIGN STUDIO ARCHITECTS LTD FOR ANY DISCREPANCIES, ERRORS OR OMISSIONS THAT MAY BE PRESENT AND NO GUARANTEE IS OFFERED AS TO THE ACCURACY OF THE INFORMATION SHOWN. THIS DRAWING IS FOR REFERENCE ONLY. PLEASE REPORT ANY DISCREPANCIES TO THE DESIGNER BEFORE ANY WORKS COMMENCE. ALL DIMENSIONS TO BE CHECKED ON SITE BEFORE ANY WORKS COMMENCE. DESIGN STUDIO ARCHITECTS LTD. 2013 - COPYRIGHT RESERVED.